



Colliers International  
1850 Mount Diablo Boulevard, Suite 200  
Walnut Creek, CA 94596 | United States  
www.colliers.com


LEASING AGENT

**Matt Hurd**  
**(925) 279-5567**


matt.hurd@colliers.com

**Scott Ellis**  
**(925) 279-5575**

scott.ellis@colliers.com

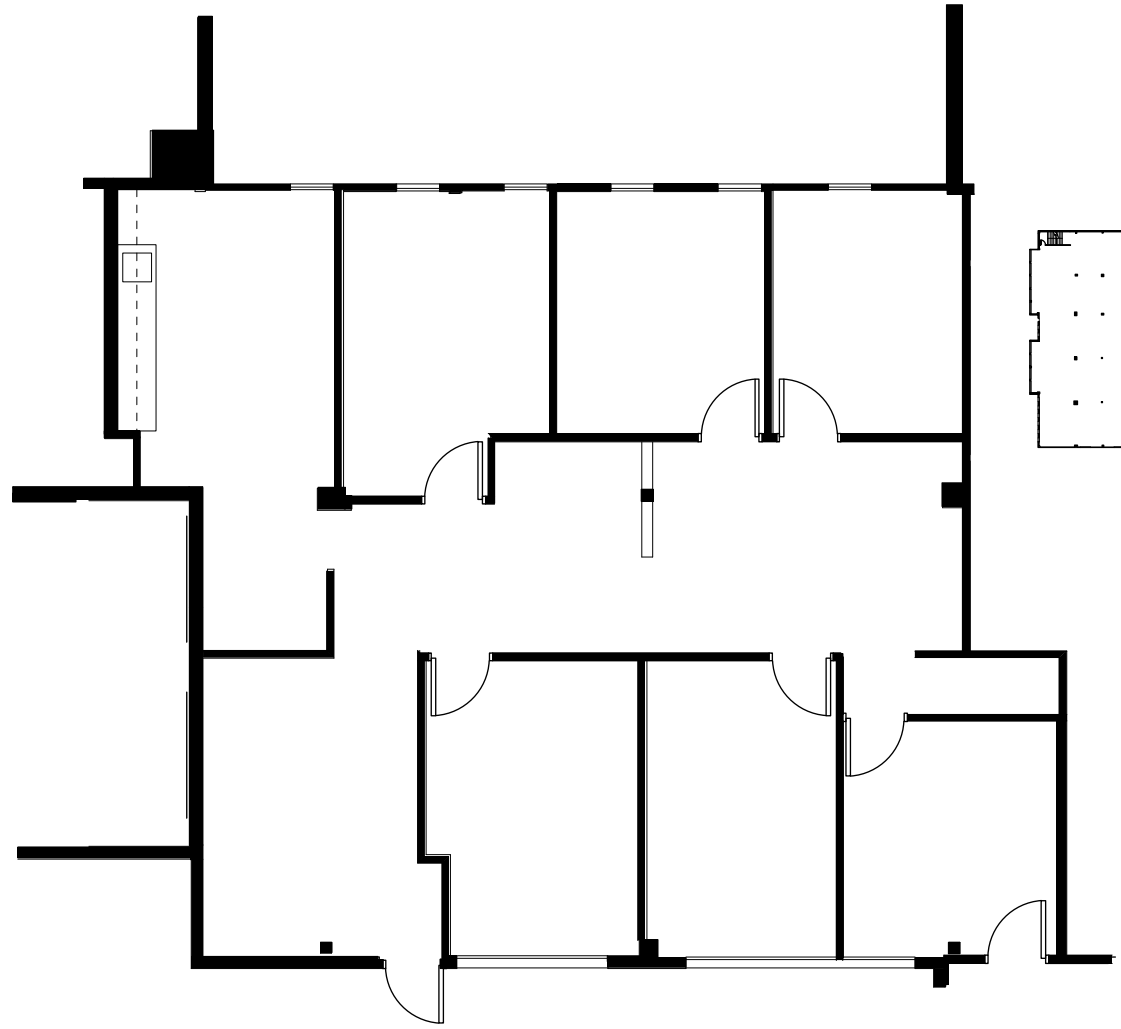

**SUITE 301**

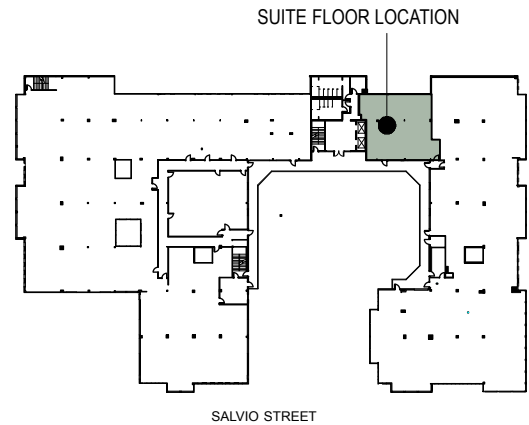

**THIRD FLOOR KEY PLAN**

**Salvio Pacheco Square**

2151 Salvio Street  
Concord, CA 94520

Third Floor

Owned & Managed by:

**LeFever Mattson**

Approximate Area Calculations  
Subject To Verification:

2,022 rsf

**As-built Plan To Be Verified**

This information displayed while not guaranteed has been secured by sources we believe to be reliable. This information is subject to errors & omissions. Any tenant should conduct their own investigation.

Plan Revision - 3-27-19